



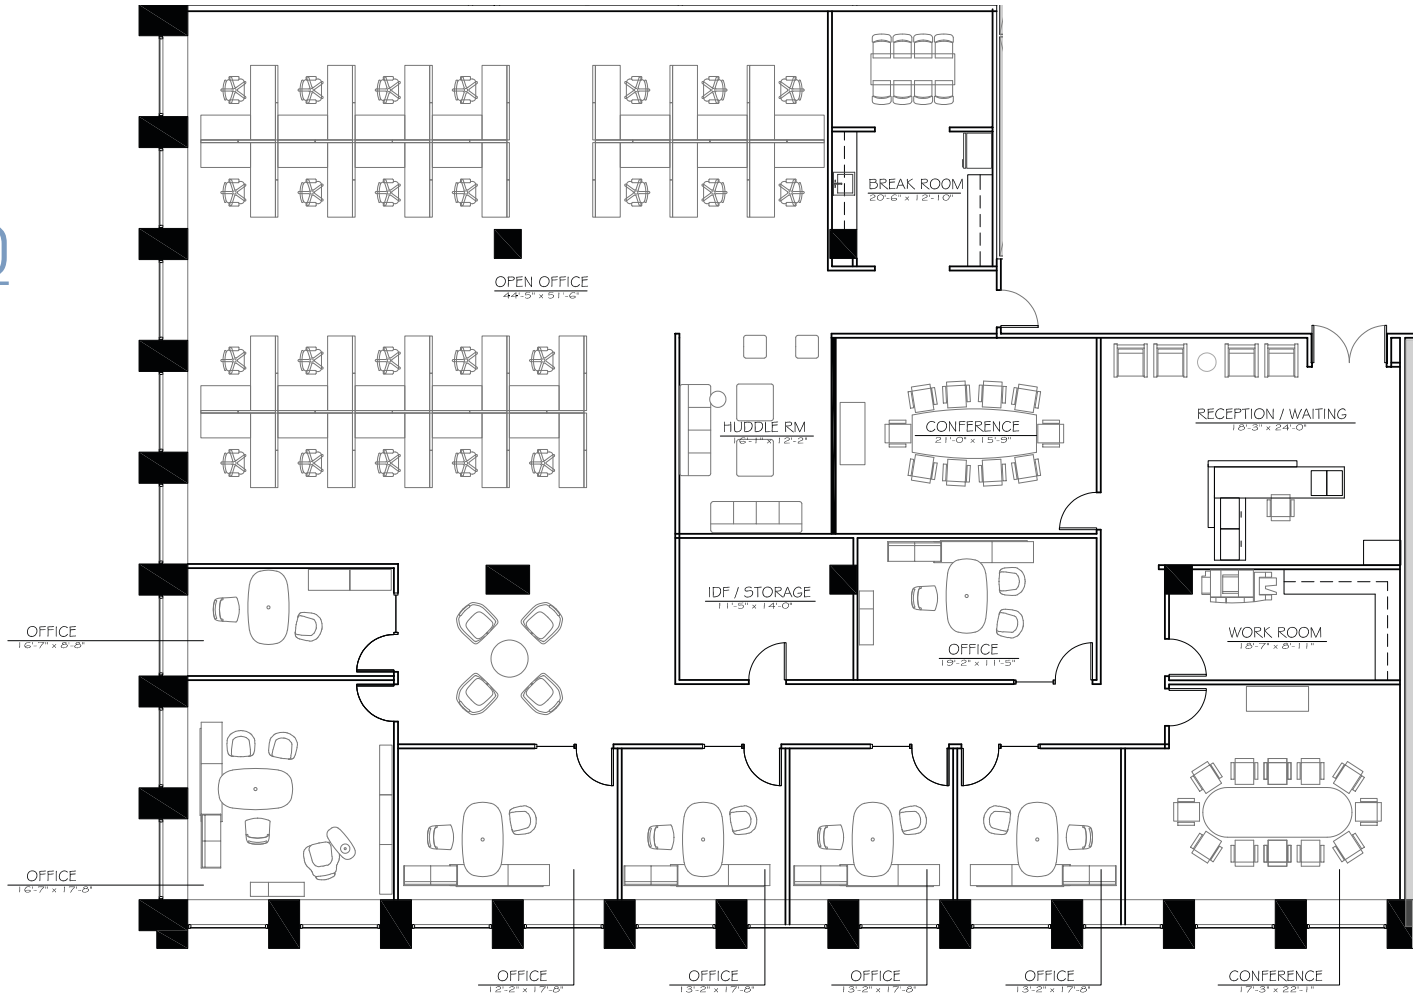

222 SOUTH
RIVERSIDE
PLAZA
FIFTH THIRD CENTER

SUITE 1850

AS BUILT
7,723 RSF

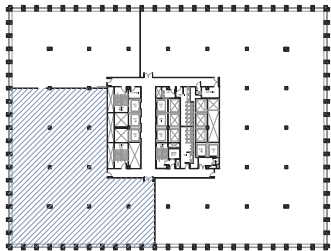

MANAGED AND LEASED BY:

ON BEHALF OF:



BRAD DESPOT
312 228 2033
brad.despot@am.jll.com

KIM DOYLE
312 228 3157
kim.doyle@am.jll.com

